


UPS - SEATTLE HUB

SEATTLE, WA

(PROJECT NO. 11057)

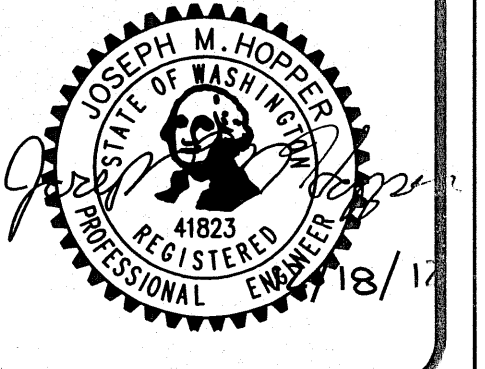

GENERAL NOTES


1. THE INFORMATION DEPICTED ON THIS MAP REPRESENTS THE RESULTS OF A SURVEY MADE ON THE DATE INDICATED AND CAN ONLY BE CONSIDERED AS INDICATING THE GENERAL CONDITION EXISTING AT THAT TIME.
2. UNDERGROUND UTILITIES WERE LOCATED BASED ON THE SURFACE EVIDENCE OF UTILITIES (I.E. PAINT MARKS, SAW CUTS IN PAVEMENT, COVERS, LIDS ETC.) THE CONTRACTOR SHALL VERIFY THE EXACT LOCATION, ELEVATION AND SIZE OF EXISTING UTILITIES PRIOR TO CONSTRUCTION.
3. TREE SIZES WERE LOCATED & SPECIES DETERMINED TO THE BEST OF OUR ABILITY. HOWEVER, T.Y.EE SURVEYORS DOES NOT WARRANT THE ACCURACY OF SIZE & SPECIES SHOWN HEREON. ANY TREES CONSIDERED TO BE CRITICAL SHOULD BE VERIFIED BY A TRAINED ARBORIST.
4. THIS MAP DOES NOT PURPORT TO SHOW EASEMENTS OF RECORD, IF ANY.
5. NO PROPERTY CORNERS WERE SET IN CONJUNCTION WITH THIS SURVEY.

REFERENCES


- 1 BOUNDARY FROM RECORD OF SURVEY RECORDED IN VOLUME 47, PAGE 62, RECORDING NUMBER 8510319008.

EQUIPMENT & PROCEDURES

FIELD SURVEY CONDUCTED USING A COMBINATION OF GPS USING A REFERENCE NETWORK AND A 3" ELECTRONIC TOTAL STATION WAS USED FOR THIS FIELD TRAVERSE SURVEY. SURVEY PROCEDURES MEET OR EXCEED STATE STANDARDS AS SPECIFIED BY W.A.C. 332-130 WITH REGARD TO LINEAR AND ANGULAR CLOSURES. ALL MEASURING INSTRUMENTS FOR THIS SURVEY HAVE BEEN MAINTAINED ACCORDING TO MANUFACTURERS SPECIFICATIONS AND HAVE BEEN COMPARED WITH A NATIONAL GEODETIC SURVEY CALIBRATED BASELINE WITHIN THE LAST 12 MONTHS.

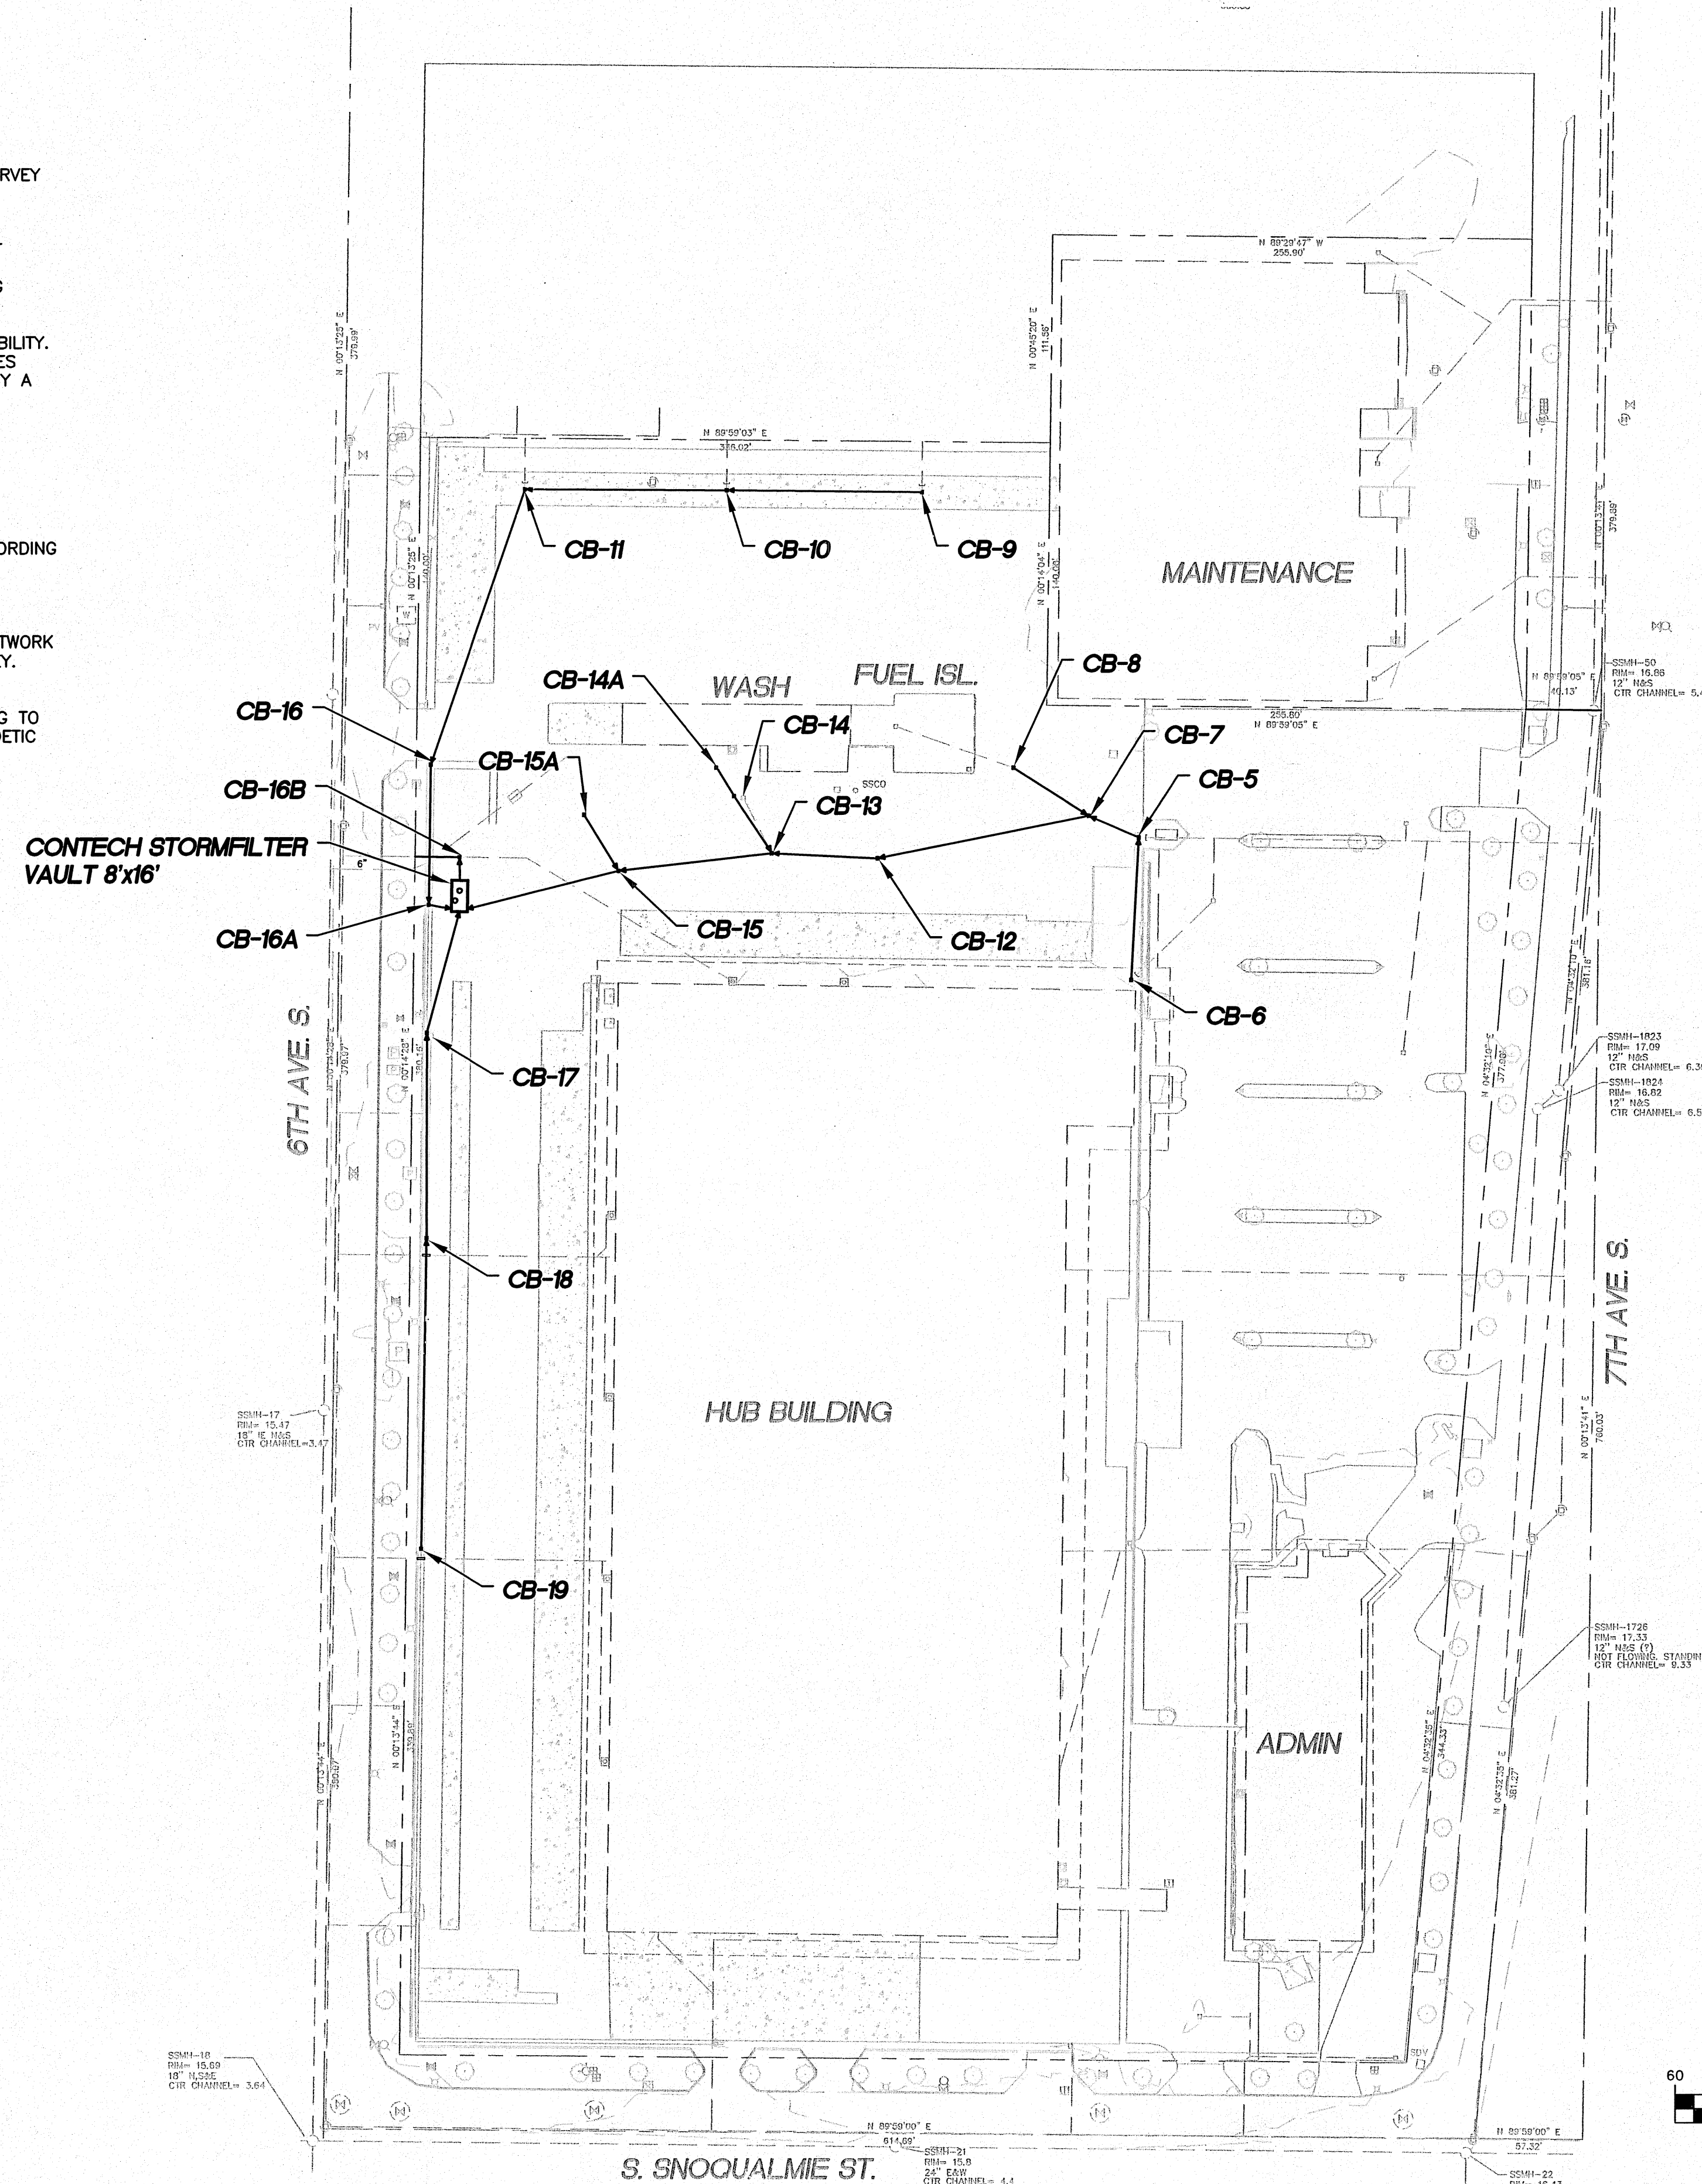

VICINITY MAP

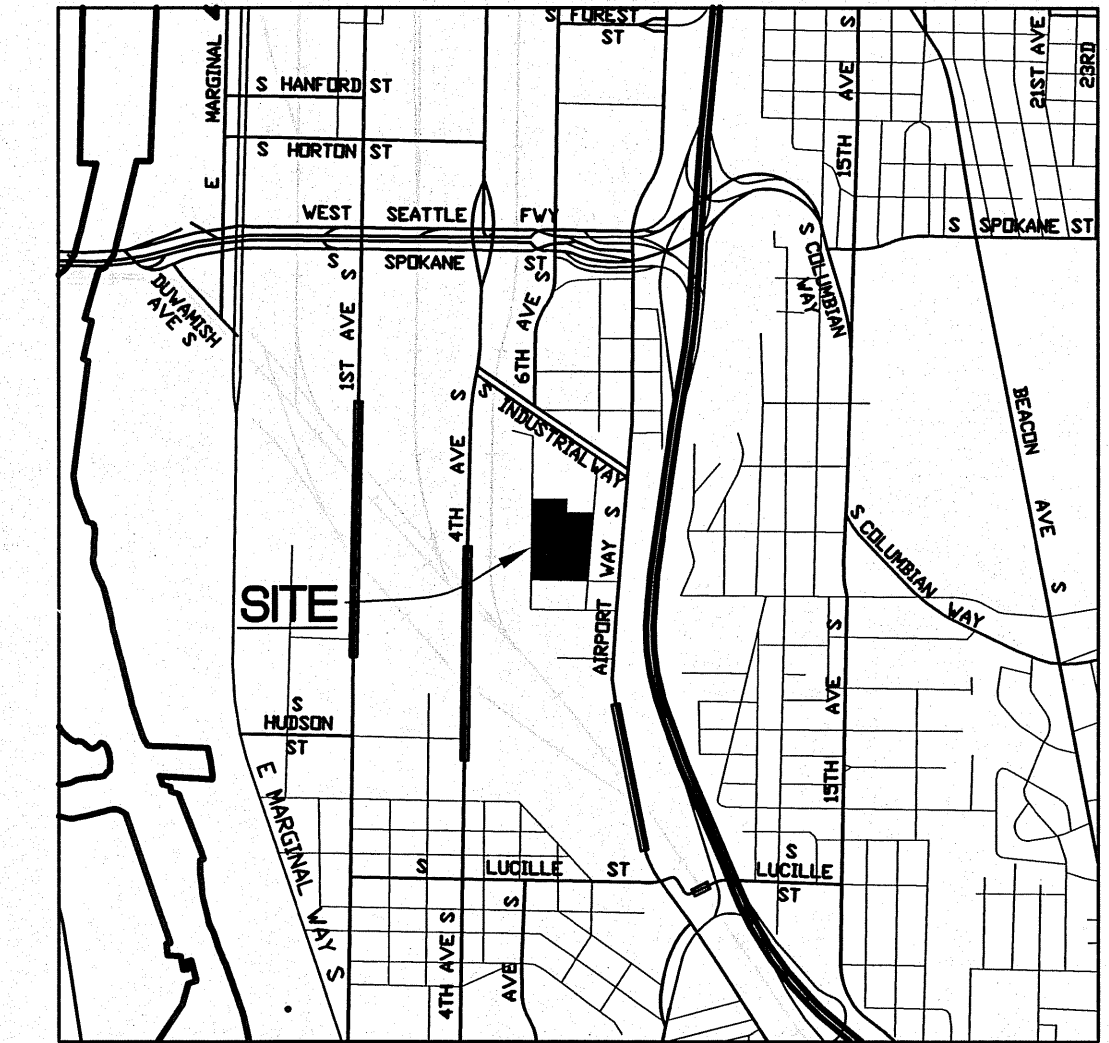

AS-BUILT SHEET INDEX

AB1	AS-BUILT COVER SHEET
AB2	AS-BUILT NORTH PLAN
AB3	AS-BUILT WEST PLAN
AB4	AS-BUILT STORM PROFILES
AB5	AS-BUILT NOTES AND DETAILS

OWNERS/DEVELOPERS:

UNITED PARCEL SERVICE
4455 7TH AVE S
SEATTLE, WA 98108
TREAIR SMITH - FACILITY SUPERVISOR
(206) 621-6380

CIVIL ENGINEER:

PACIFIC ENGINEERING DESIGN, LLC
15445 53RD AVE S.
SEATTLE, WA 98188
JOE HOPPER
PHONE: (206) 431-7970
FAX: (206) 388-1648


SURVEYORS:

ORIGINAL TOPOGRAPHY:
TYEE SURVEYORS
7537 11TH AVE. NE
SEATTLE, WA 98115
TIM GRIFFIN, PLS
PHONE: (206) 525-3660

AS-BUILTS:
BASE LINE ENGINEERING, INC.
1910 64TH AVE. W.
FIRCREST, WA 98466
GARY ALLEN, PLS
PHONE: (253) 565-4491

LEGEND

- | | | | |
|------|--------------------------|---|----------------------------|
| CB | CATCH BASIN | ○ | BOLLARD |
| FEC | FACE OF EXTRUDED CURB | □ | CATCH BASIN |
| FH | FIRE HYDRANT | ⊠ | ELECTRICAL JUNCTION BOX |
| FVC | FACE OF VERTICAL CURB | ⊕ | FIRE DEPARTMENT CONNECTION |
| GV | GAS VALVE | ⊗ | FIRE HYDRANT |
| ICV | IRRIGATION CONTROL VALVE | ⊗ | GAS/POWER METER(AS NOTED) |
| IE | INVERT ELEVATION | ⊗ | GAS VALVE |
| MW | MONITORING WELL | ⊗ | INDICATOR POST |
| PM | POWER METER | ⊗ | IRRIGATION CONTROL VALVE |
| PP | POWER POLE | ⊗ | LIGHT STANDARD |
| PPL | POWER POLE W/LIGHT | ⊗ | POWER METER |
| PPU | POWER POLE W/UNDERGROUND | ⊗ | POWER POLE(AS NOTED) |
| PTL | POWER POLE W/XFMR&LIGHT | ⊗ | POWER VAULT |
| PV | POWER VAULT | ⊗ | PROPANE TANK |
| SDMH | STORM DRAIN MANHOLE | ⊗ | SANITARY SEWER CLEANOUT |
| SLI | SOLID LOCKING LID | ⊗ | SANITARY SEWER MANHOLE |
| SSCO | SANITARY SEWER CLEANOUT | ⊗ | STORM DRAIN MANHOLE |
| SSMH | SANITARY SEWER MANHOLE | ⊗ | LIGHT STANDARD |
| WM | WATER METER | ⊗ | POWER METER |
| WV | WATER VALVE | ⊗ | POWER POLE(AS NOTED) |
| □ | CONCRETE HATCH | ⊗ | POWER VAULT |
| ⊠ | TRANSFORMER | ⊗ | PROPANE TANK |
| ⊗ | WATER METER | ⊗ | SANITARY SEWER CLEANOUT |
| ⊗ | WATER VALVE | ⊗ | SANITARY SEWER MANHOLE |
| ⊗ | WATER MANHOLE | ⊗ | STORM DRAIN MANHOLE |
| ⊗ | DECIDUOUS(AS NOTED) | ⊗ | LIGHT STANDARD |

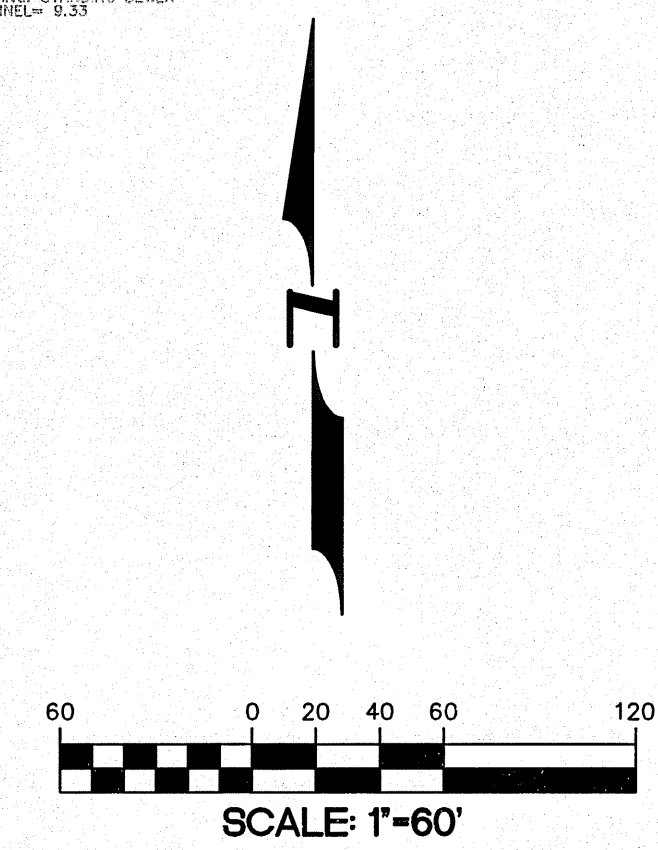

15445 53RD AVE. S.
SEATTLE, WA 98188
PHONE: (206) 431-7970
FAX: (206) 388-1648
WEB SITE: PACENG.COM

Pacific Engineering Design, LLC
Civil Engineering and Planning Consultants

CITY OF SEATTLE, WA

AS-BUILTS
UPS - SEATTLE HUB

PROJECT NO.: 11057
DRAWN BY: ENM
ISSUE DATE: 12/18/2012
SHEET REV.:

AS-BUILT COVER SHEET

11057CV01.DWG
AB1
SHEET 01 OF 05