



15445 53RD AVE. S.  
SEATTLE, WA 98188  
PHONE: (206) 431-7970  
FAX: (206) 388-1648  
WEB SITE: PACENG.COM

Pacific  
Engineering  
Design, LLC

Civil Engineering and  
Planning Consultants


AS-BUILTS  
UPS - SEATTLE HUB  
CITY OF SEATTLE, WA

FOR:  
UNITED PARCEL SERVICE  
4485 7TH AVE. S.  
SEATTLE, WA 98108

PROJECT NO.: 11057  
DRAWN BY: ENM  
ISSUE DATE: 12/18/2012  
SHEET REV.:

AS-BUILT  
NORTH PLAN

11057GR01.DWG  
**AB2**  
SHEET 02 OF 05

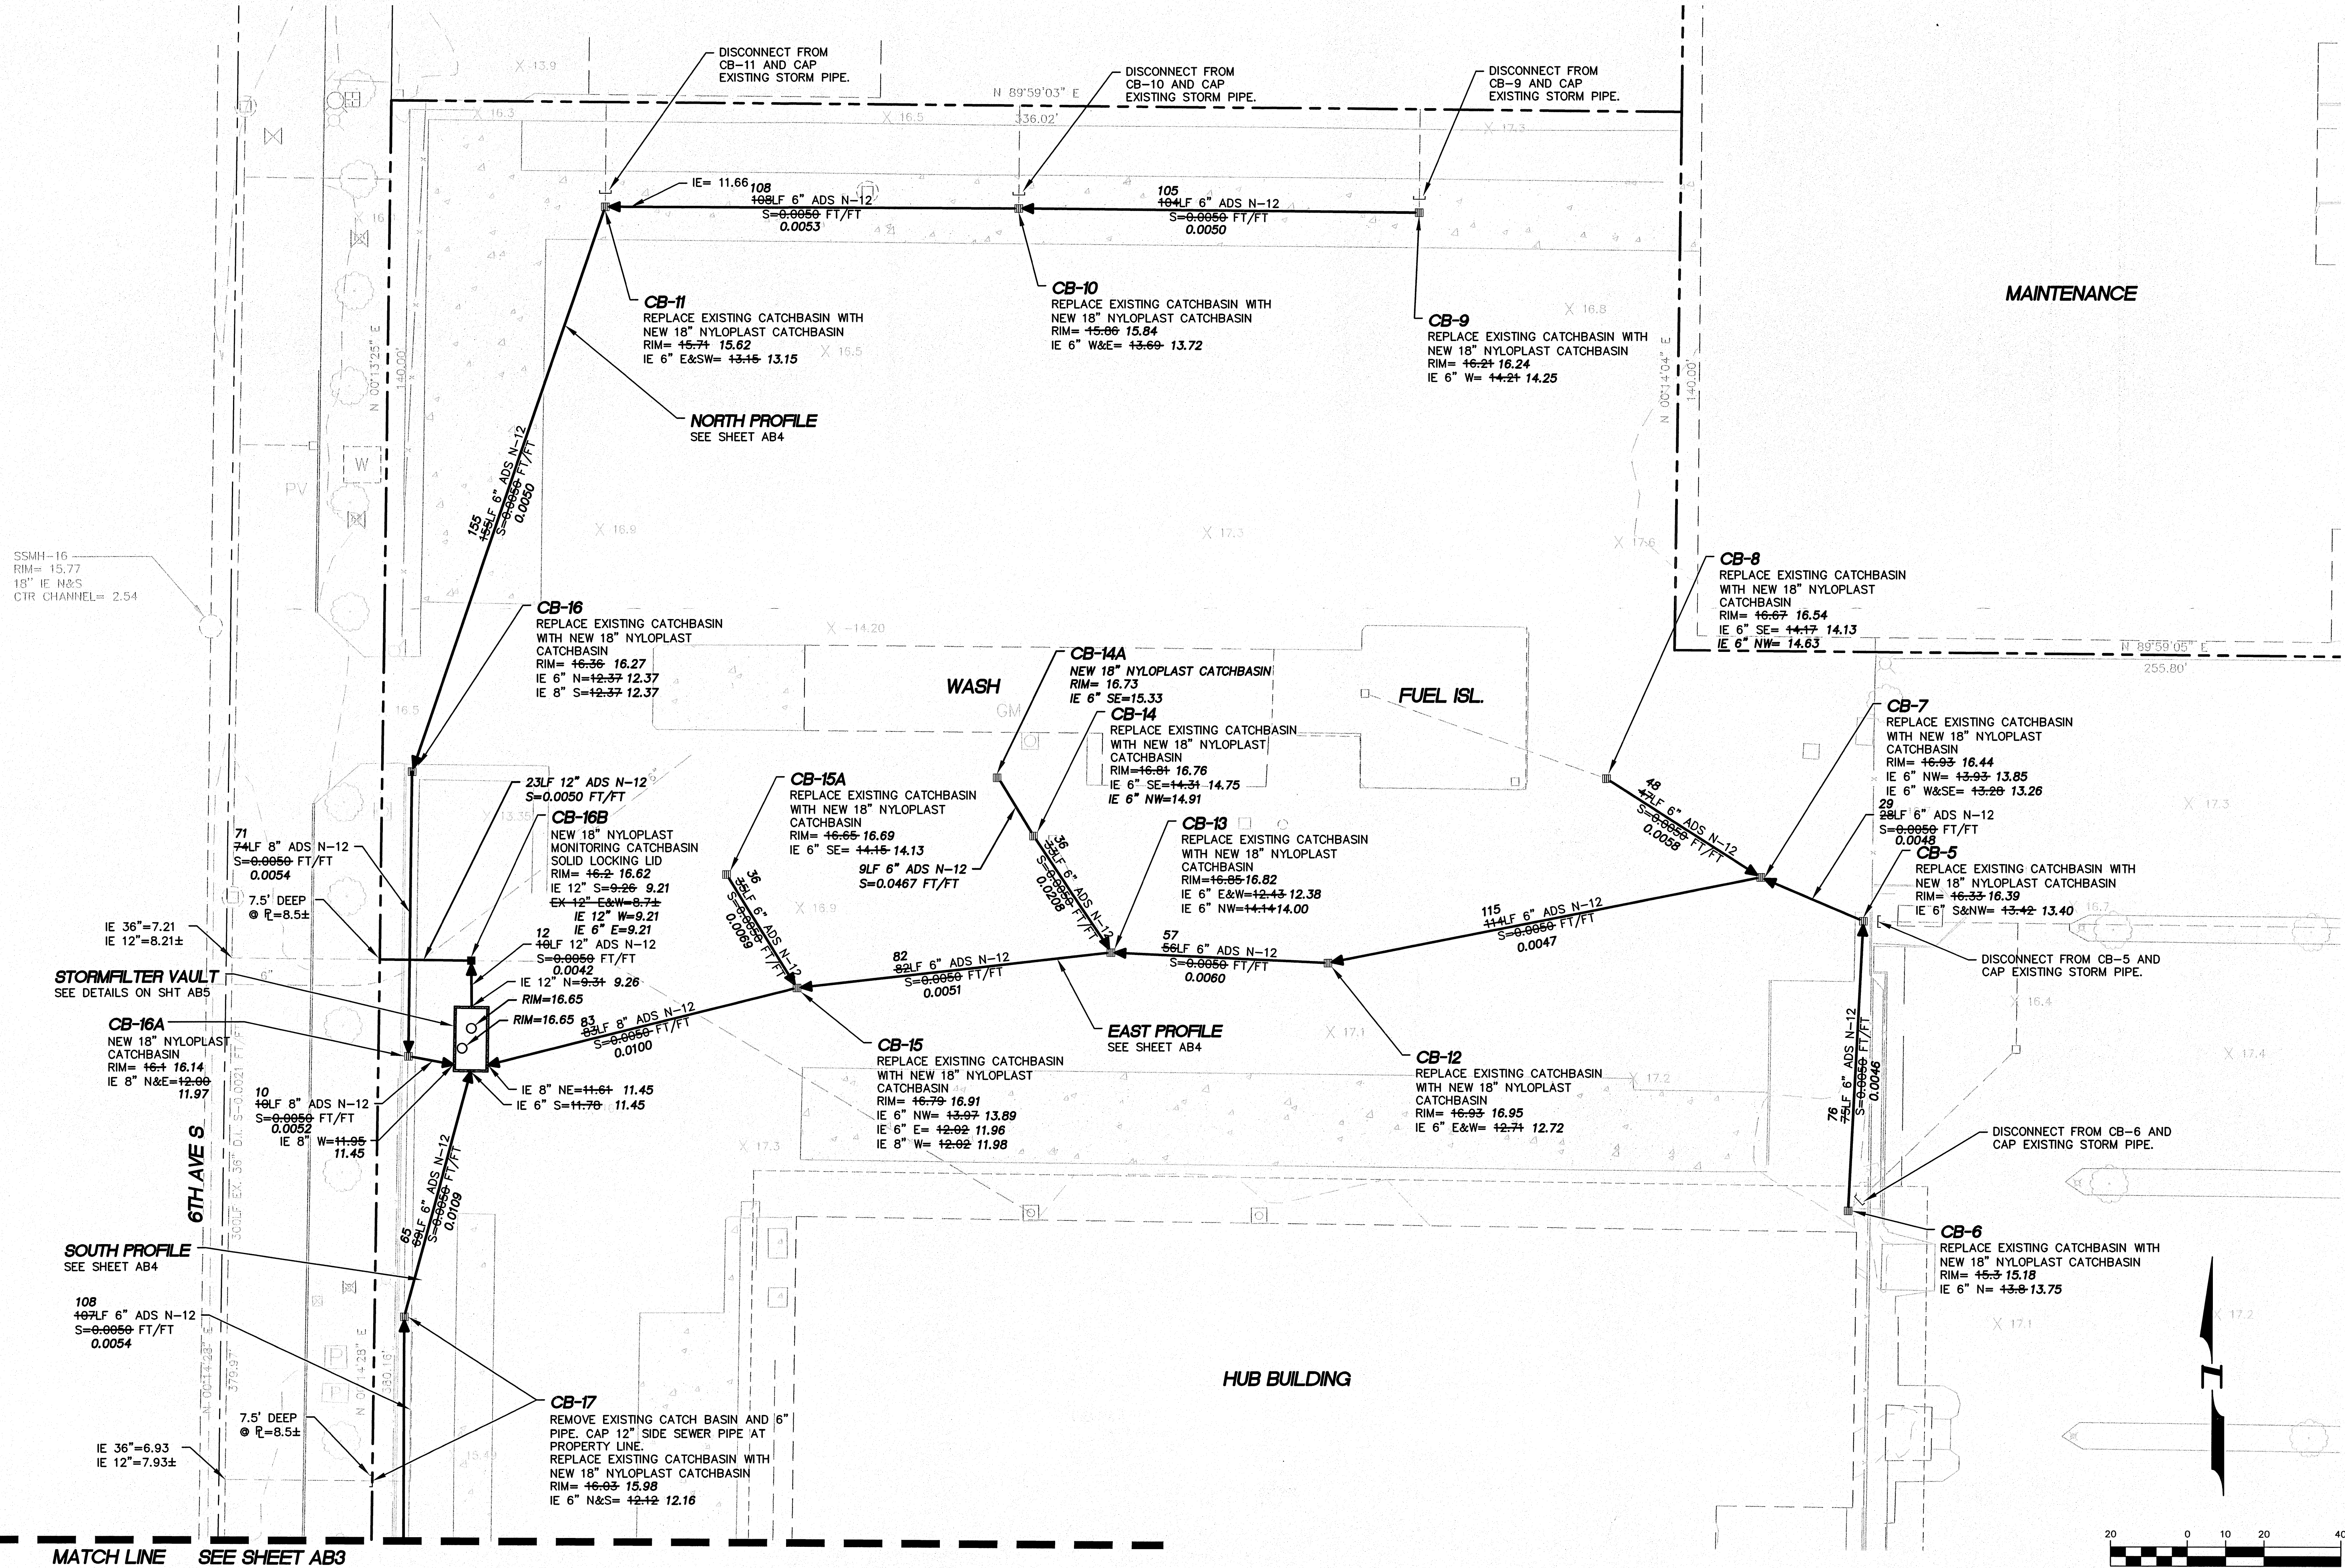

MAINTENANCE

WASH

FUEL ISL.

HUB BUILDING

NORTH PROFILE  
SEE SHEET AB4

EAST PROFILE  
SEE SHEET AB4

SOUTH PROFILE  
SEE SHEET AB4

MATCH LINE SEE SHEET AB3

