
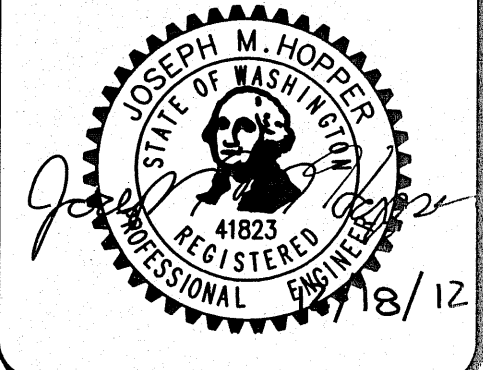
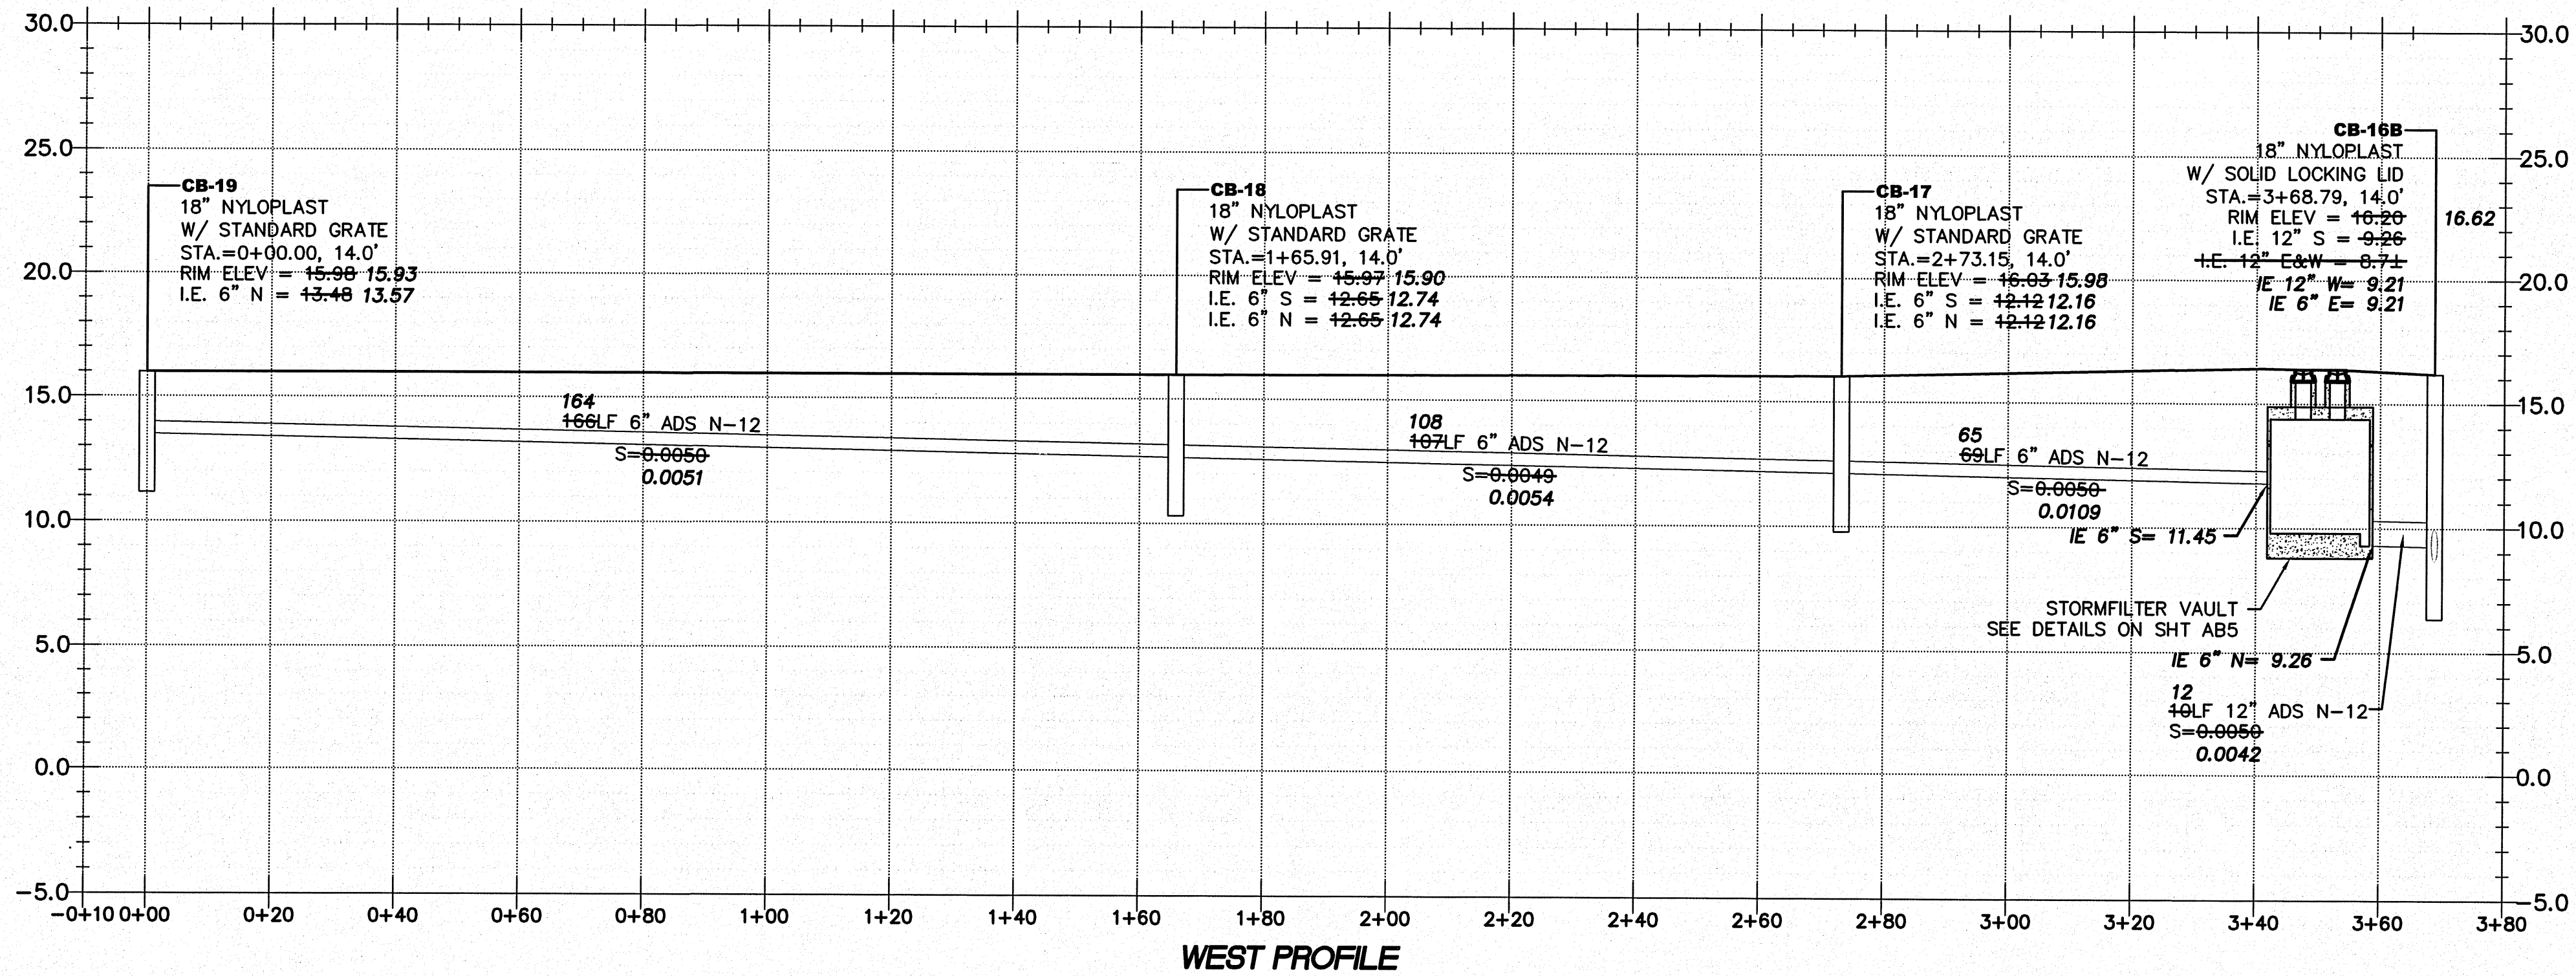
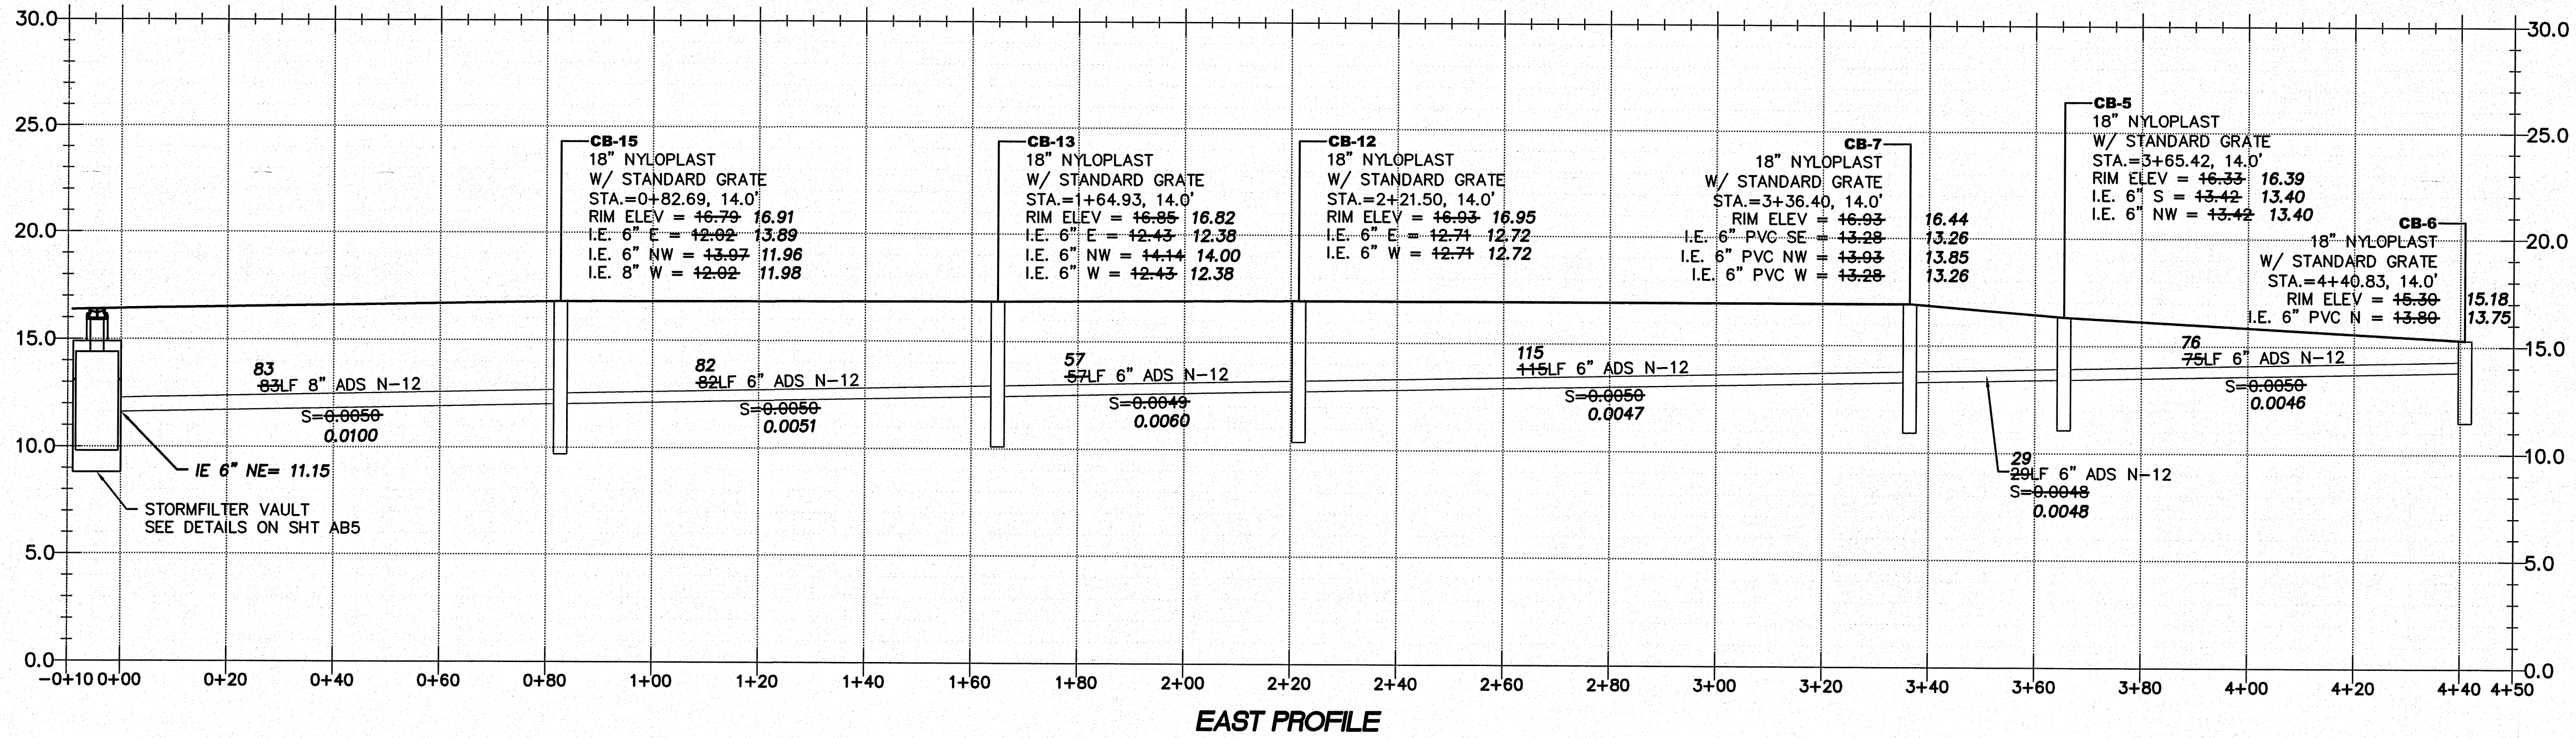


SW 1/4, SW 1/4 SEC. 20, T. 26 N., R. 5 E., W.M.

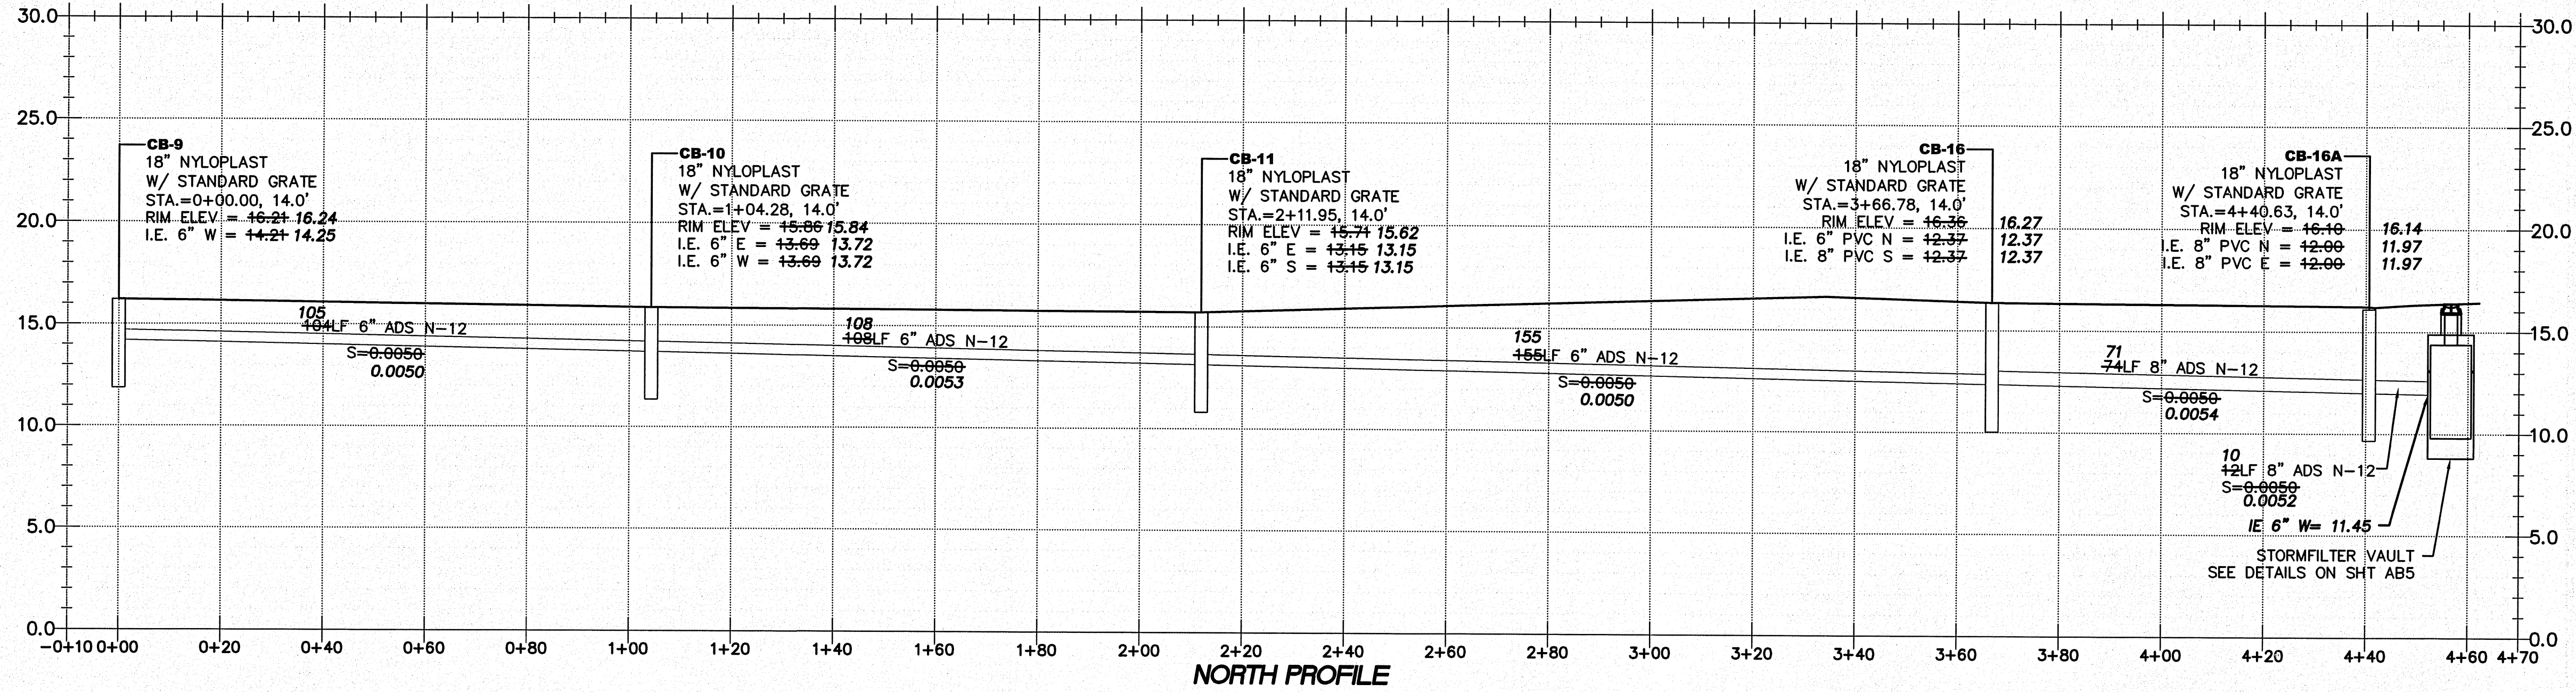

15445 53RD AVE. S.  
 SEATTLE, WA 98188  
 PHONE: (206) 431-7970  
 FAX: (206) 388-1648  
 WEB SITE: PACENG.COM

**Pacific Engineering Design, LLC**  
 Civil Engineering and Planning Consultants

**AS-BUILTS UPS - SEATTLE HUB**  
 CITY OF SEATTLE, WA  
 FOR: UNITED PARCEL SERVICE  
 4455 7TH AVE. S.  
 SEATTLE, WA 98108

PROJECT NO.: 11057  
 DRAWN BY: ENM  
 ISSUE DATE: 12/18/2012  
 SHEET REV.:

AS-BUILT STORM PROFILES

11057PROF01.DWG  
**AB4**  
 SHEET 04 OF 05