


KEYMAP

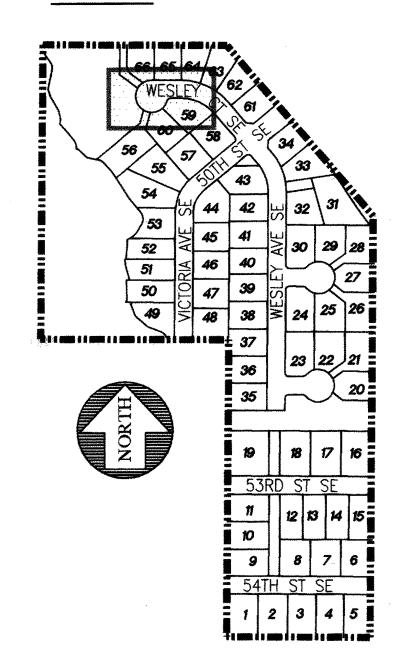

LEGEND

	-0-	SANITARY SEWER CLEANOUT
	•	SANITARY SEWER MANHOLE
	¥₩⇒	FIRE HYDRANT ASSEMBLY
		CAP, WATER MAIN W/TEMPORARY 2" BLOWOFF ASSEMBLY
	28 —	WATER METER
	,Y ,	ELBOW
	II I)	CB TYPE I
	•	CB TYPE I W/SOLID LOCKING LID
		CB TYPE II
	•	CB TYPE II W/SOLID LOCKING LID
	and the state of t	PROPOSED EASEMENT
		PROPOSED 6" ROOF DRAIN CONNECTION
		EXISTING PAVEMENT
		PROPOSED PAVEMENT
		PROPOSED SIDEWALK
		RETAINING WALL
	and and the states and the	BUILDING ENVELOPE
	4	SIDE SEWERS
	ے	STOP SIGN
	đ	STREET NAME SIGN
	*	BOLLARD
RECORD DRAWING CERTIFICATION		
THESE DRAWINGS CONFORM TO THE CONTRACTOR'S CONSTRUCTION RECORDS.		
		and the street to the anti-street and the second se
	1	·


PROJECT REF: FACO7-0016
HS May 10, 2013
THESE PLANS ARE "APPROVED" FOR CONFORMANCE WITH
THE CITY OF AUBURN'S ENGINEERING DIVISION
REQUIREMENTS.

TITLE/POSITION:

CONFIRMED BY CITY:

APPROVED BY: Denni 5-16

DATE APPROVED: 5/15/13

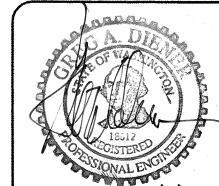

31-7970 38-1648 5.COM

ering SEATTLE, WARE SITE: WARE SI

Design, LL

CITY OF AUBURN

STATES

THWEST, LLC.

IL BUILDERS

INUE SOUTH, PMB#2

ARK, WA 98148

PROJECT NO.: **12022**

DRAWN BY: ENM

SHEET REV.: **3-20-2013**

ROAD AND STORM PLAN AND PROFILE (WESLEY CT. STA. 0+00-1+80)

05056RD10-C14.DWG

C 26
SHEET 26 OF 55