

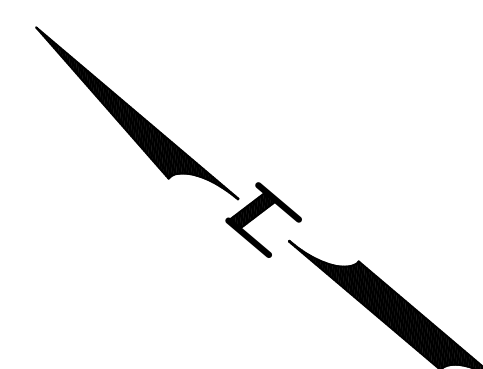
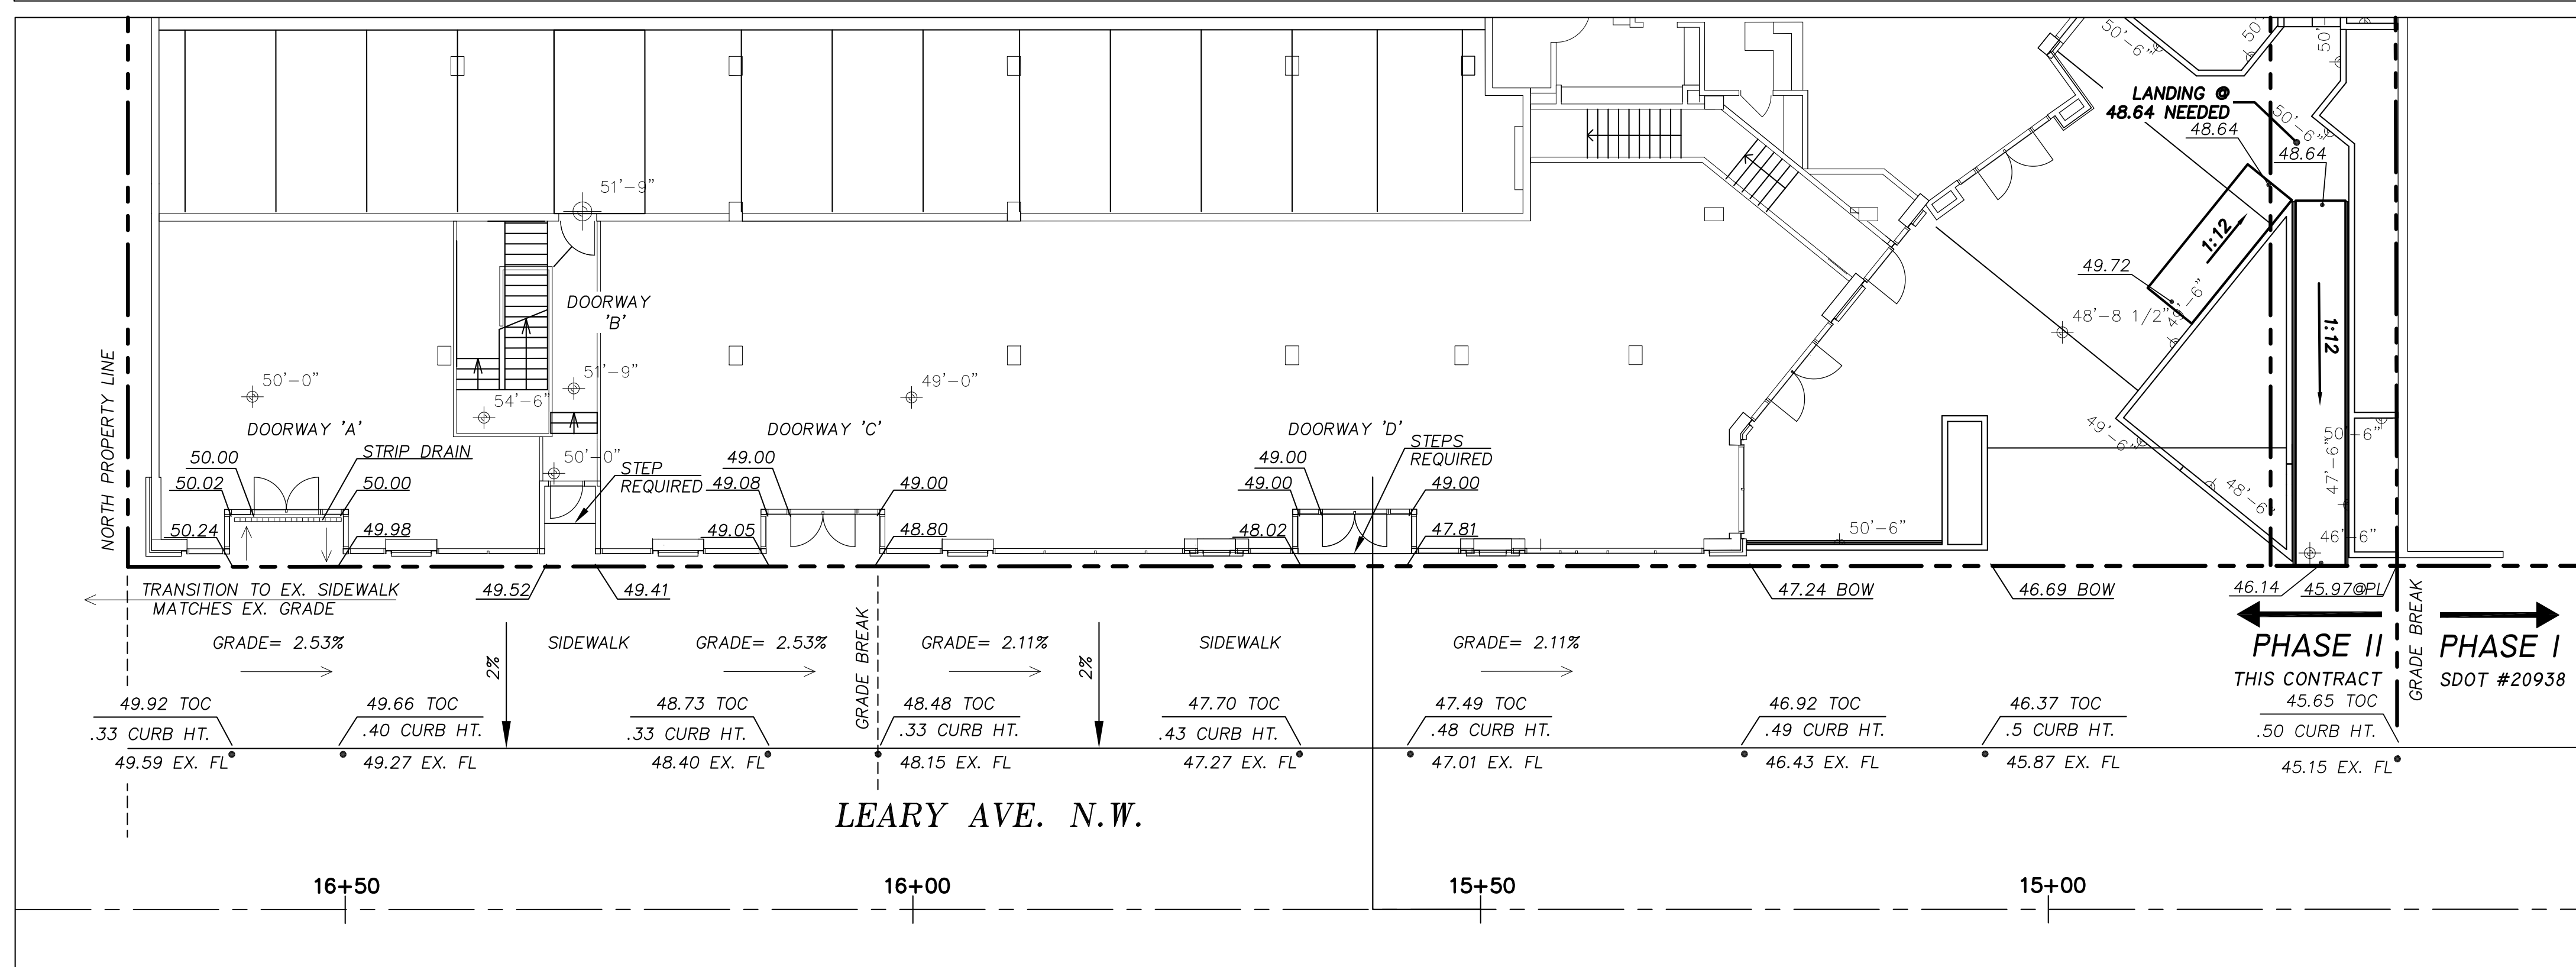
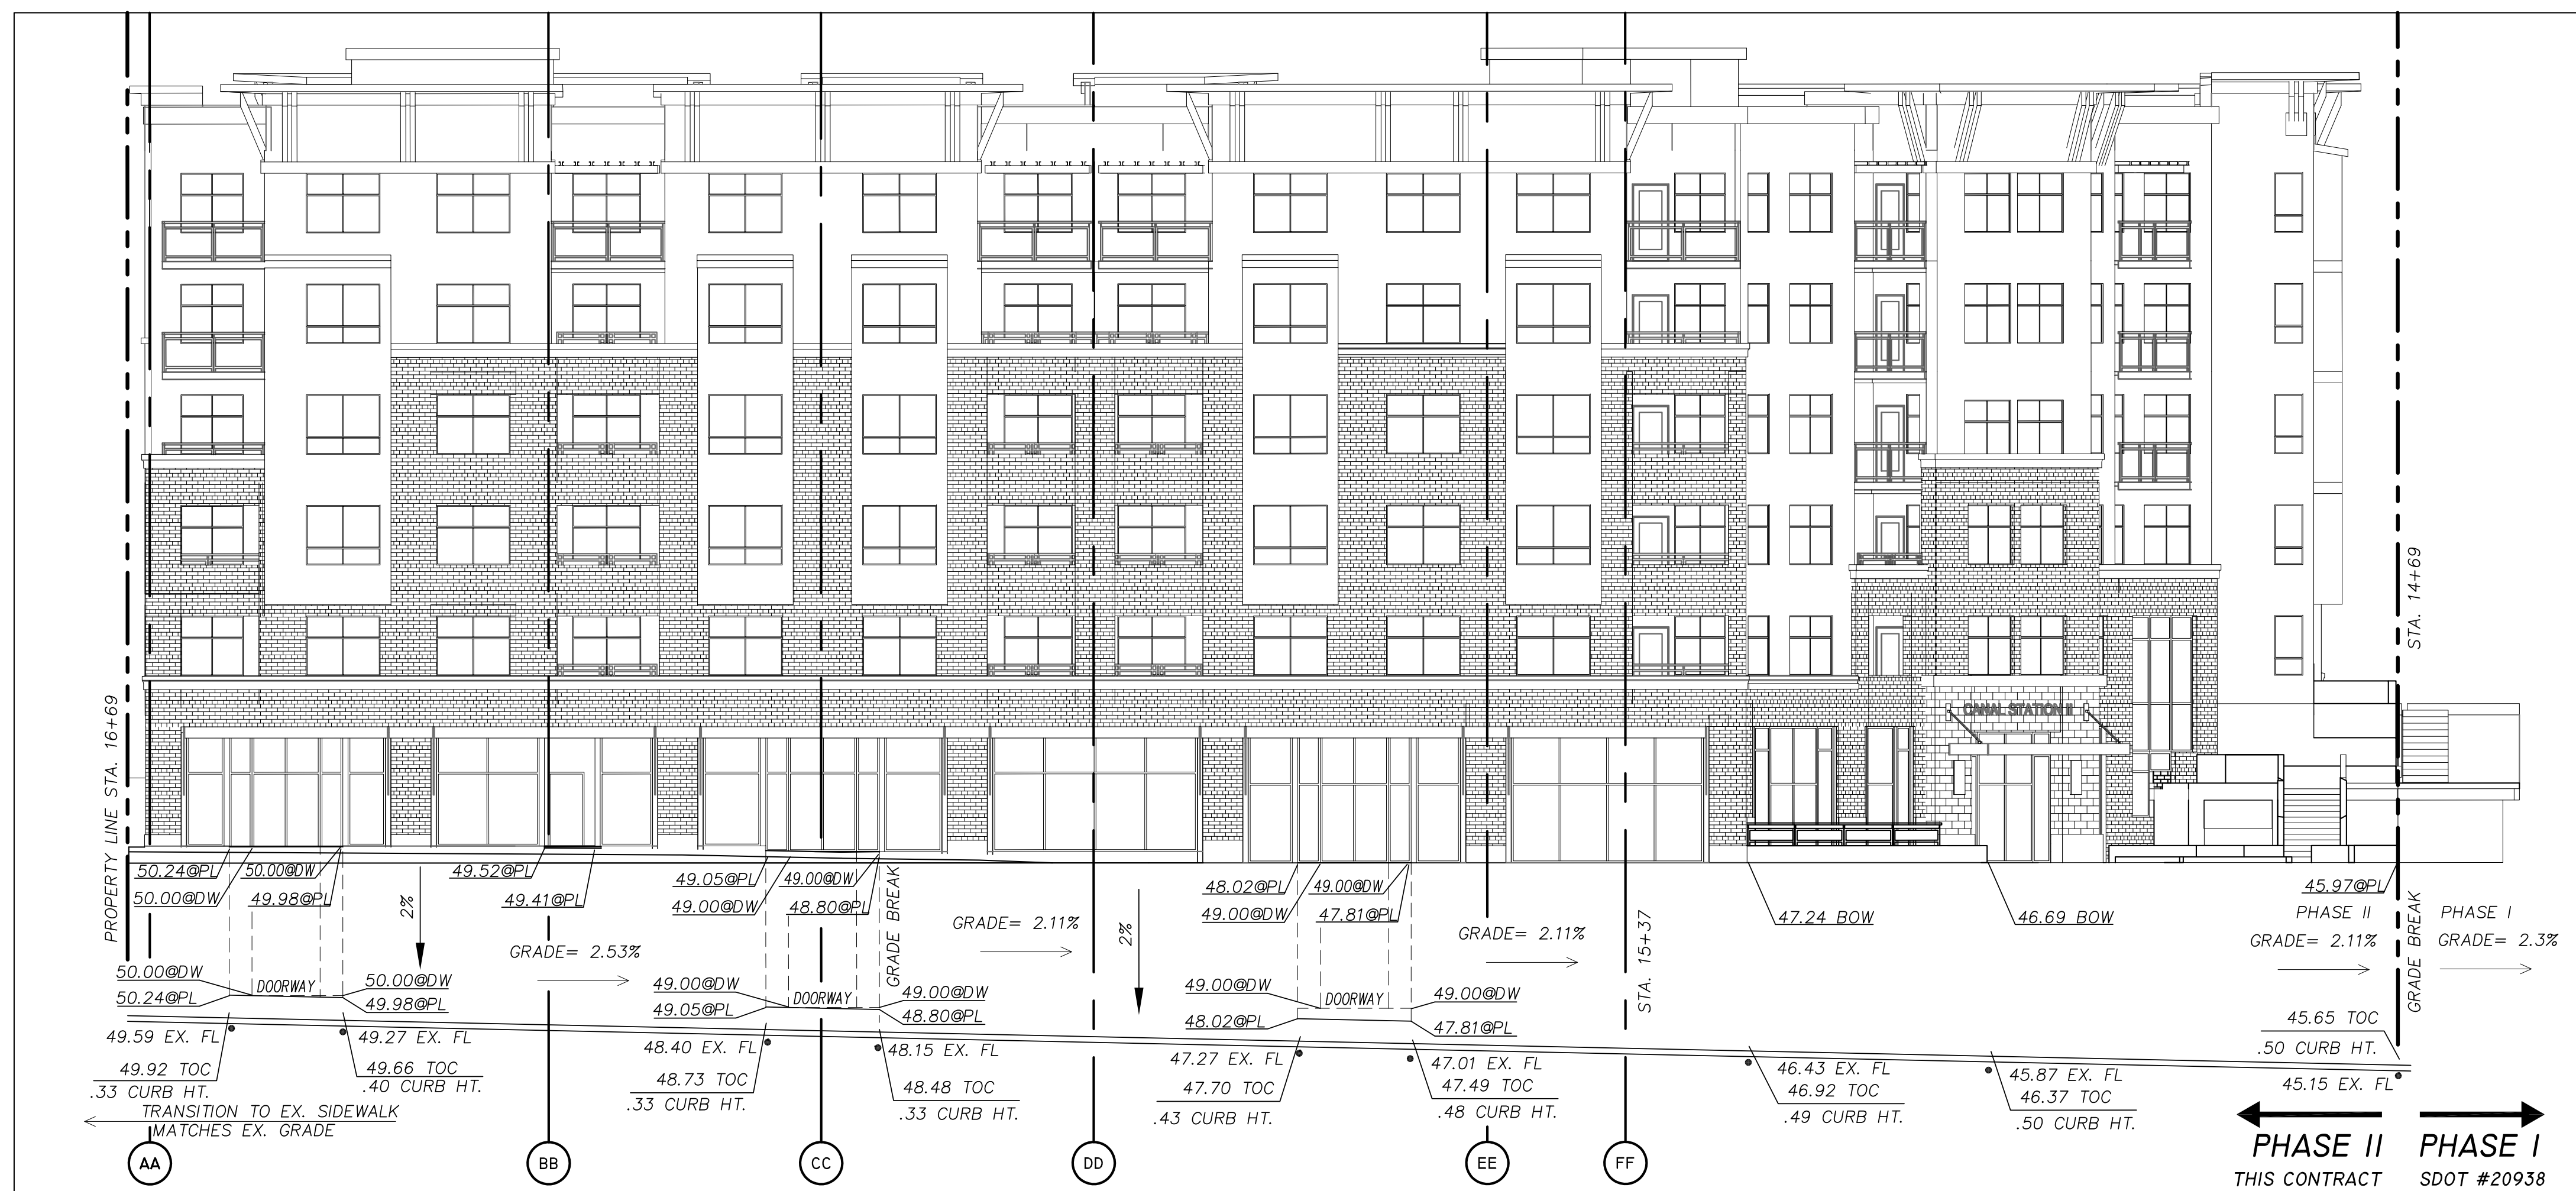


SCALE: 1" = 10'

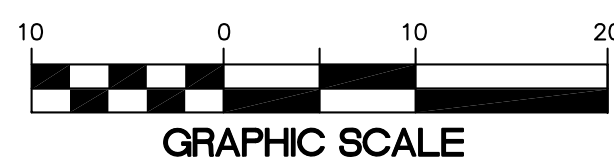

NOTE: AS-BUILT SURVEY INFORMATION BY CTS SURVEYORS 04/05/07

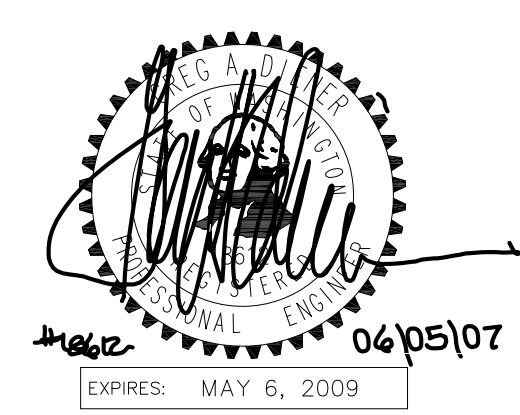

Pacific Engineering Design, LLC
 Civil Engineering & Planning Consultants
 15445 53rd Ave. South
 Seattle, WA, 98188
 PHONE: (206) 431-7970
 FAX: (206) 388-1648
 WEB SITE: www.paceng.com

NAME OR INITIALS AND DATE	INITIALS AND DATE
DESIGNED: L. LARSEN	REVIEWED:
CHECKED: G. DIENER	PLAN REVIEW ANALYST.....
DRAWN: D. WHITE	PLAN REVIEW SEC. MGR.....
CHECKED: G. DIENER	RECEIVED.....
DESIGN REVIEW	REVISED AS-BUILT.....

All work done in accordance with the City of Seattle Standard Plans and Specifications in effect on the date shown above, and supplemented by Special Provisions.

City of Seattle
Seattle Department of Transportation

WORK ORDER NO. TWS8354 SPU W/O# - NS 70045
 PERMIT NO. 49511 APPROVED
 SCALE: H:1"=20' V:1"=5' INSPECTOR'S BOOK

Canal Station Condominiums 5450 LEARY AVE. N.W.

Leary Ave. N.W. et al
 Leary Ave. N.W. Sidewalk, Curb and Drainage Improvements Plan/Profile

SDOT PROJECT NO.	49511
VAULT PLAN NO.	774-402
SHEET	2A OF 9