08/20/2010 09:48:49 10021SS01

S.E. 1/4, SEC. 27, T. 21 N., R. 4 E., W.M.

LAKEHAVEN UTILITY DISTRICT

O Water Plan Θ Sewer Plan

Dated _____

APPROVED FOR CONSTRUCTION SUBJECT TO CHANGES NOTED

The District's review is not a check of any dimension or quantities and will not relieve the Developer from responsibility for errors of any sort. No changes shall be made in the plans except by the consent of the District.

General Manager/District Engineer **Date**

This construction plan will expire one year from plan approval date, if construction has not commenced.

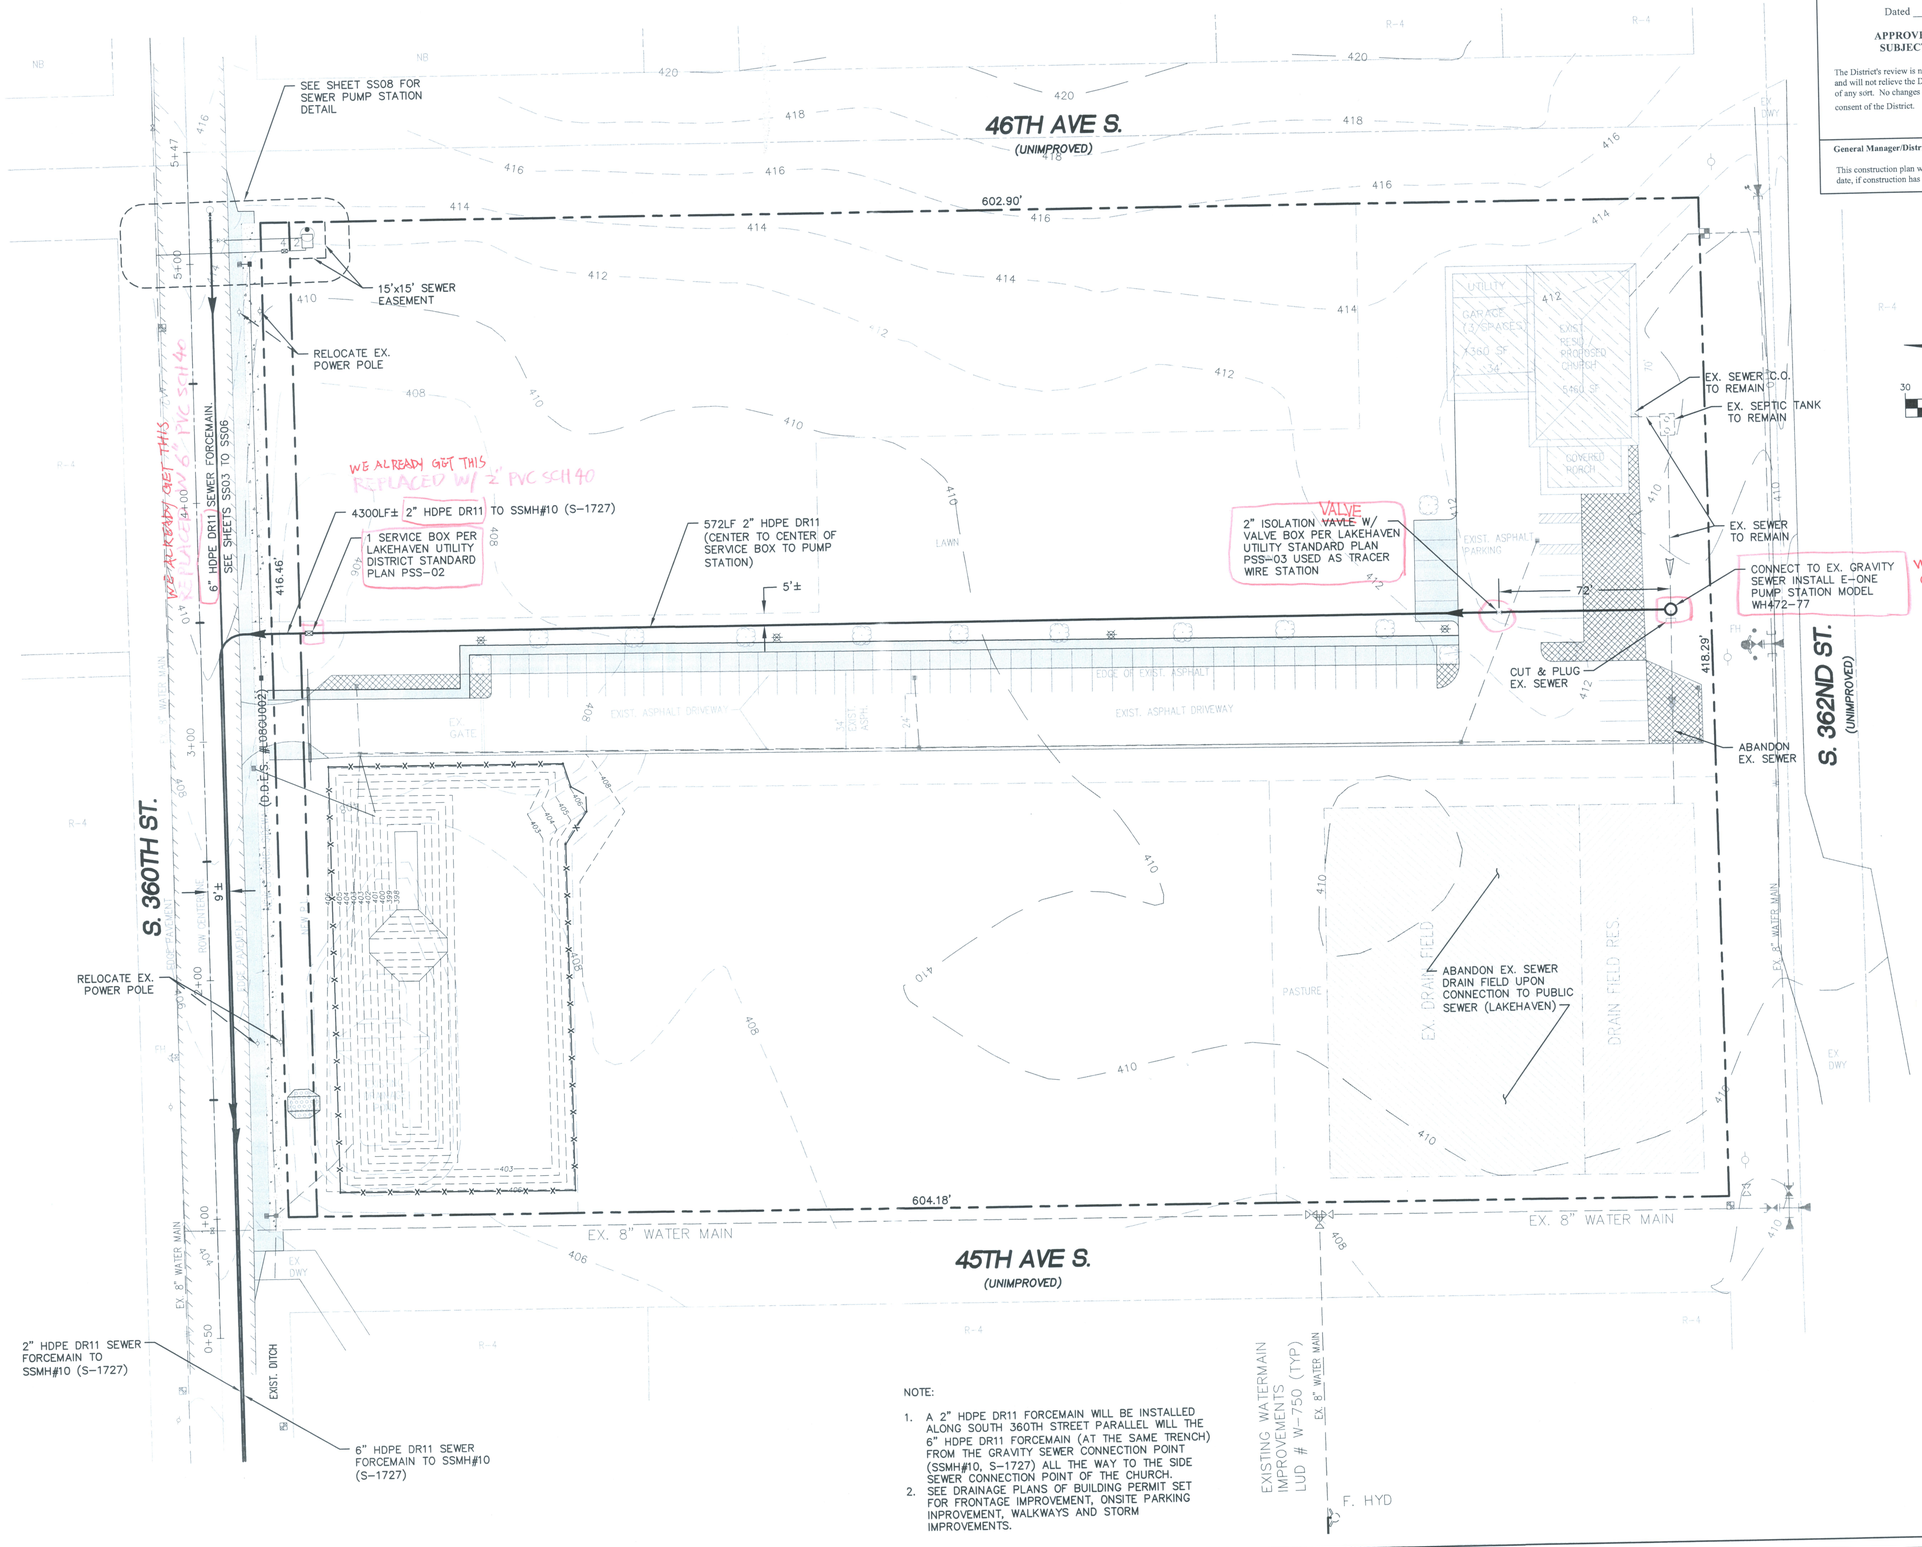

NOTE:

1. A 2" HDPE DR11 FORCEMAIN WILL BE INSTALLED ALONG SOUTH 360TH STREET PARALLEL WILL THE 6" HDPE DR11 FORCEMAIN (AT THE SAME TRENCH) FROM THE GRAVITY SEWER CONNECTION POINT (SSMH#10, S-1727) ALL THE WAY TO THE SIDE SEWER CONNECTION POINT OF THE CHURCH.
2. SEE DRAINAGE PLANS OF BUILDING PERMIT SET FOR FRONTAGE IMPROVEMENT, ONSITE PARKING INPROVEMENT, WALKWAYS AND STORM IMPROVEMENTS.

Pacific Engineering Design, LLC
Civil Engineering and Planning Consultants
15445 53RD AVE. S.
SEATTLE, WA 98188
PHONE: (206) 431-7970
FAX: (206) 388-1648
WEB SITE: PACENG.COM

LINGSONG LENG — STATE OF WASHINGTON — 32575 — REGISTERED PROFESSIONAL ENGINEER — 08/04/10

LAKEHAVEN UTILITY DISTRICT PROJECT XXXXXXXX

RAM NIWAS CHURCH

KING COUNTY, WA.

FOR:
SATGURU RAM SINGH STANG
15701 181ST PLACE SE
RENTON, WASHINGTON
PHONE (206) 304-1911

PROJECT NO.:	10021
DRAWN BY:	CJB
ISSUE DATE:	7-23-2010
SHEET REV.:	8-04-2010

SANITARY SEWER DESIGN

10021SS01.DWG

SS02